


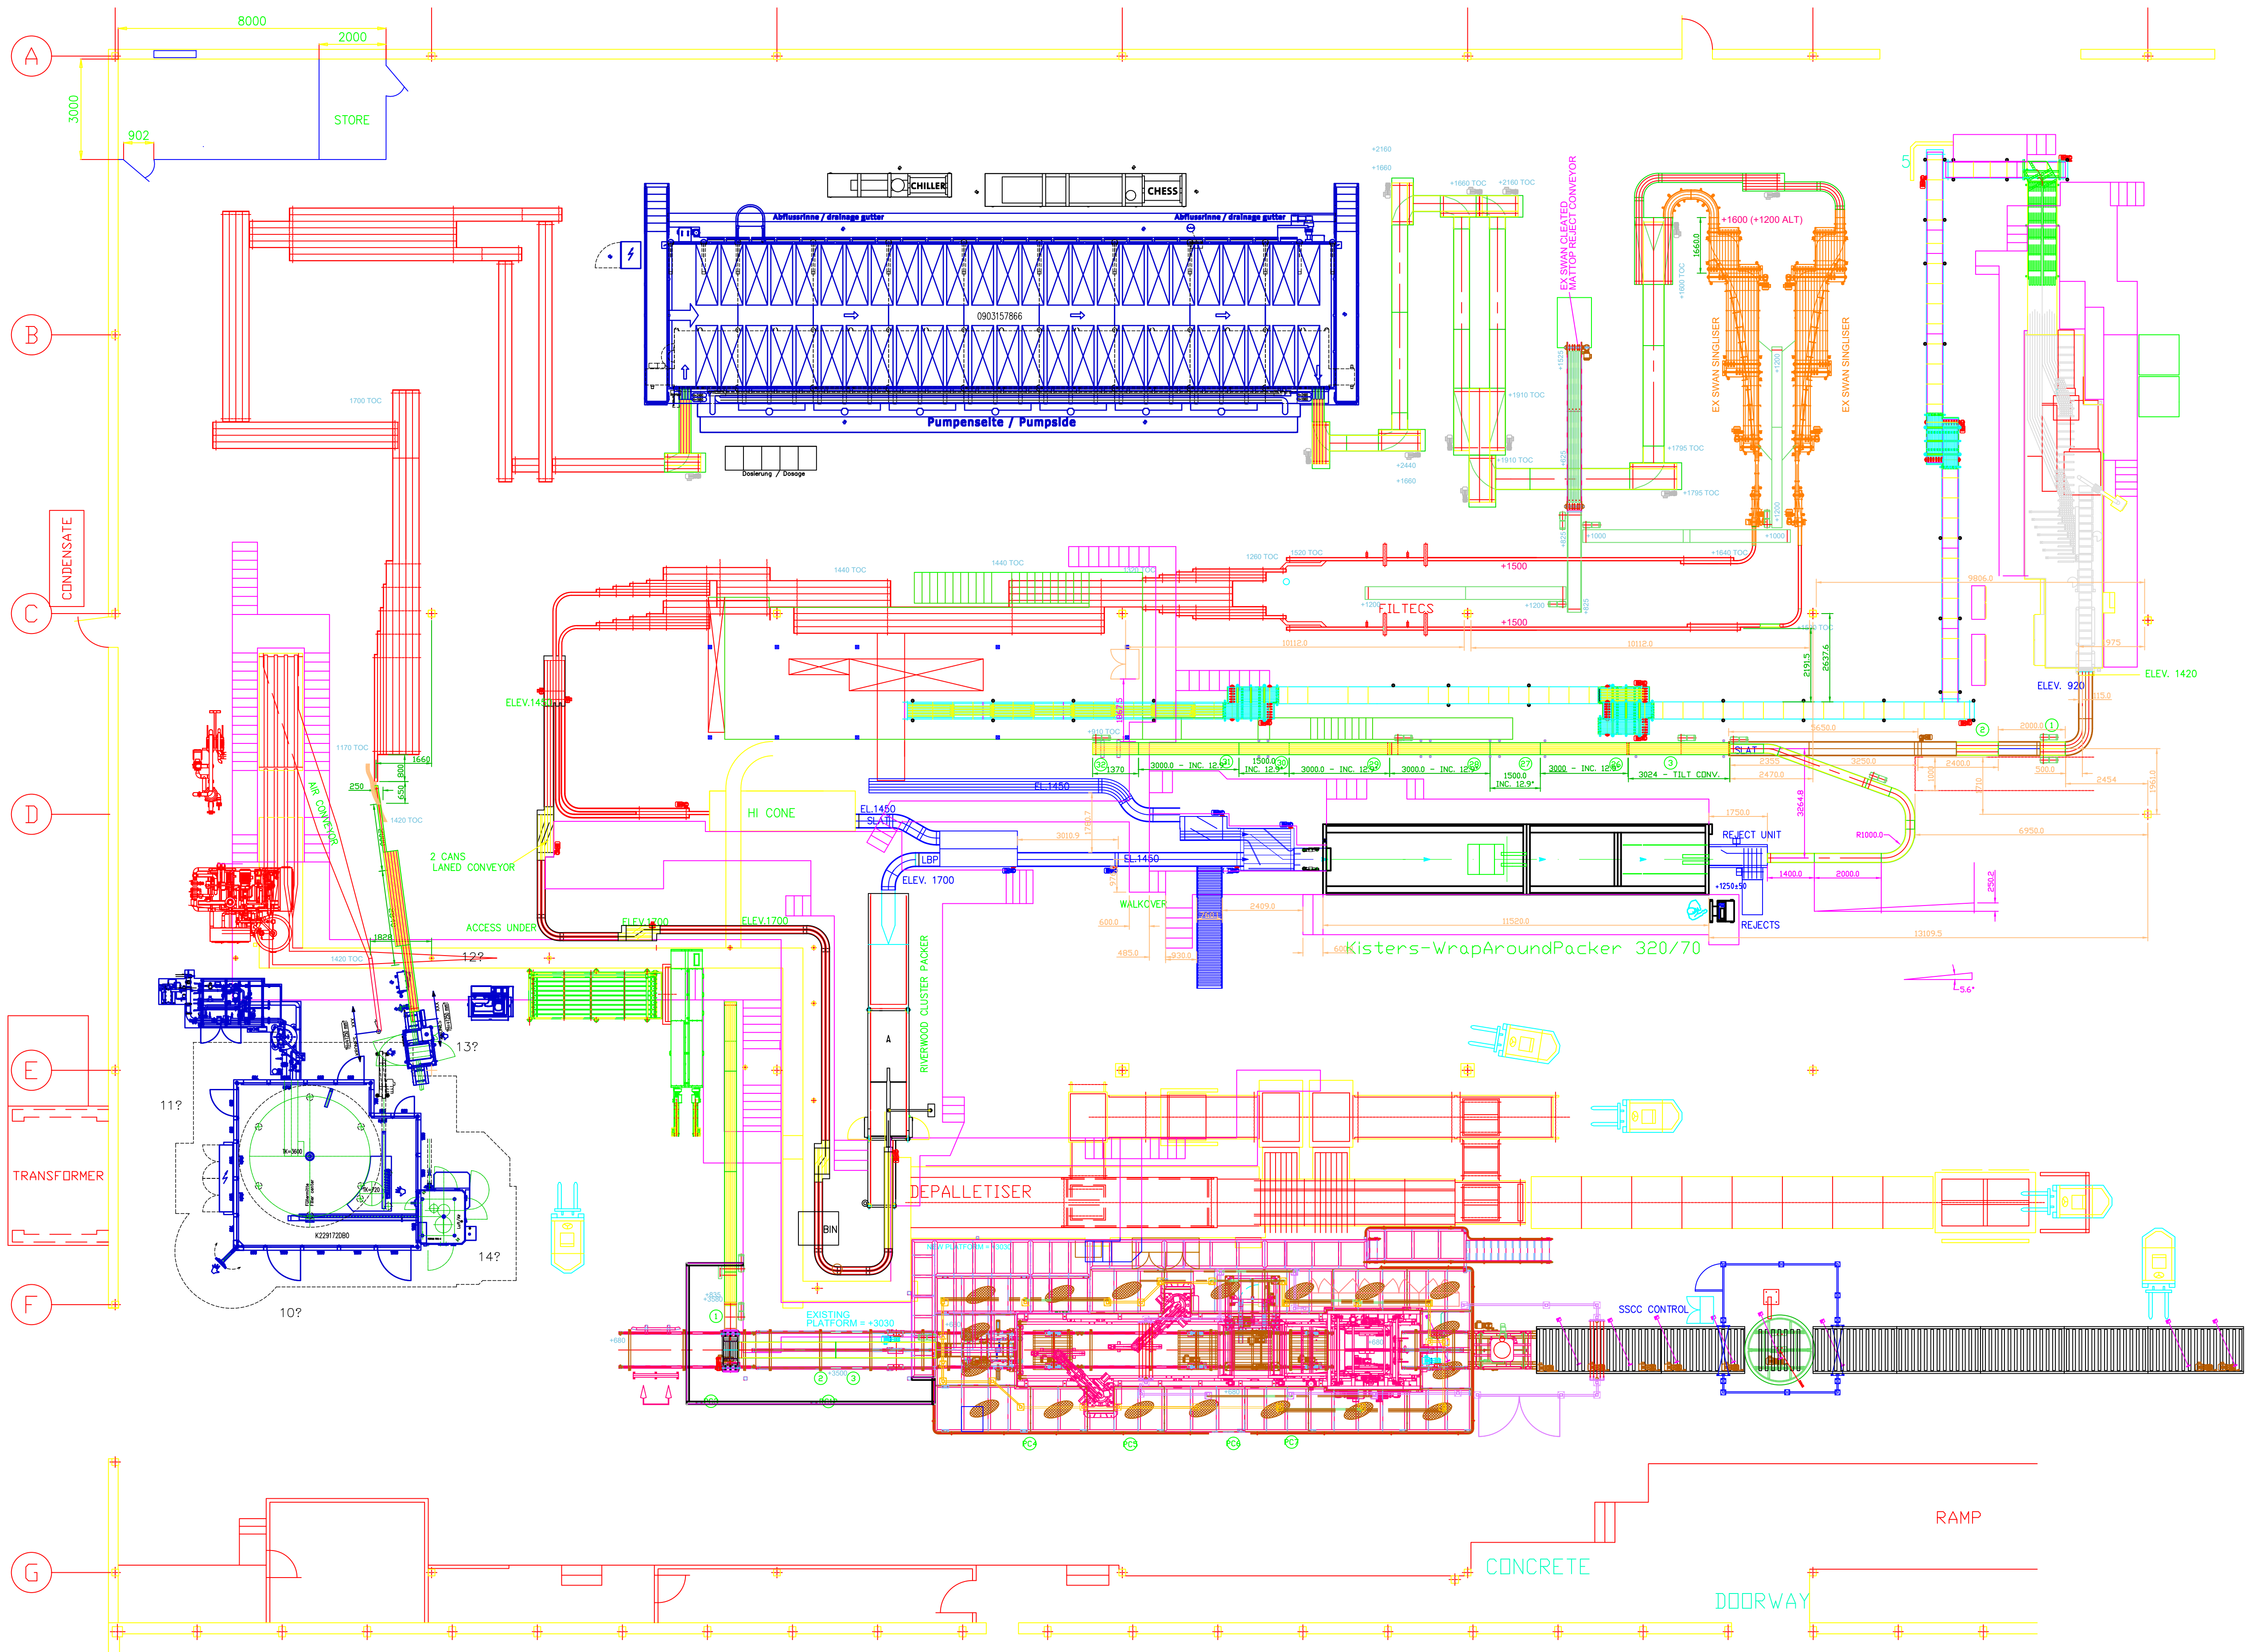

NOTES :

Customer : West End Brewery (Lion Co.)		Approved :	Reviewed :	Drawn :	Date :	Description of Current Revision :	
Reference : Project PAL - CANS		-	-	D.Halls	19/04/17	ISSUED FOR INFORMATION	
						INFORMATION ONLY	
						Drawn : D.Halls Date : 19/04/2017 A3 Scale = 1.5 x A1 Sheet Scale = 1:100	
Description : WEST END BREWERY - CAN PLANT		Client Code		Job Number	Type	Drawing	Sheet
GENERAL LAYOUT		133 - 046 - GA		001 - 01	1	Revision	